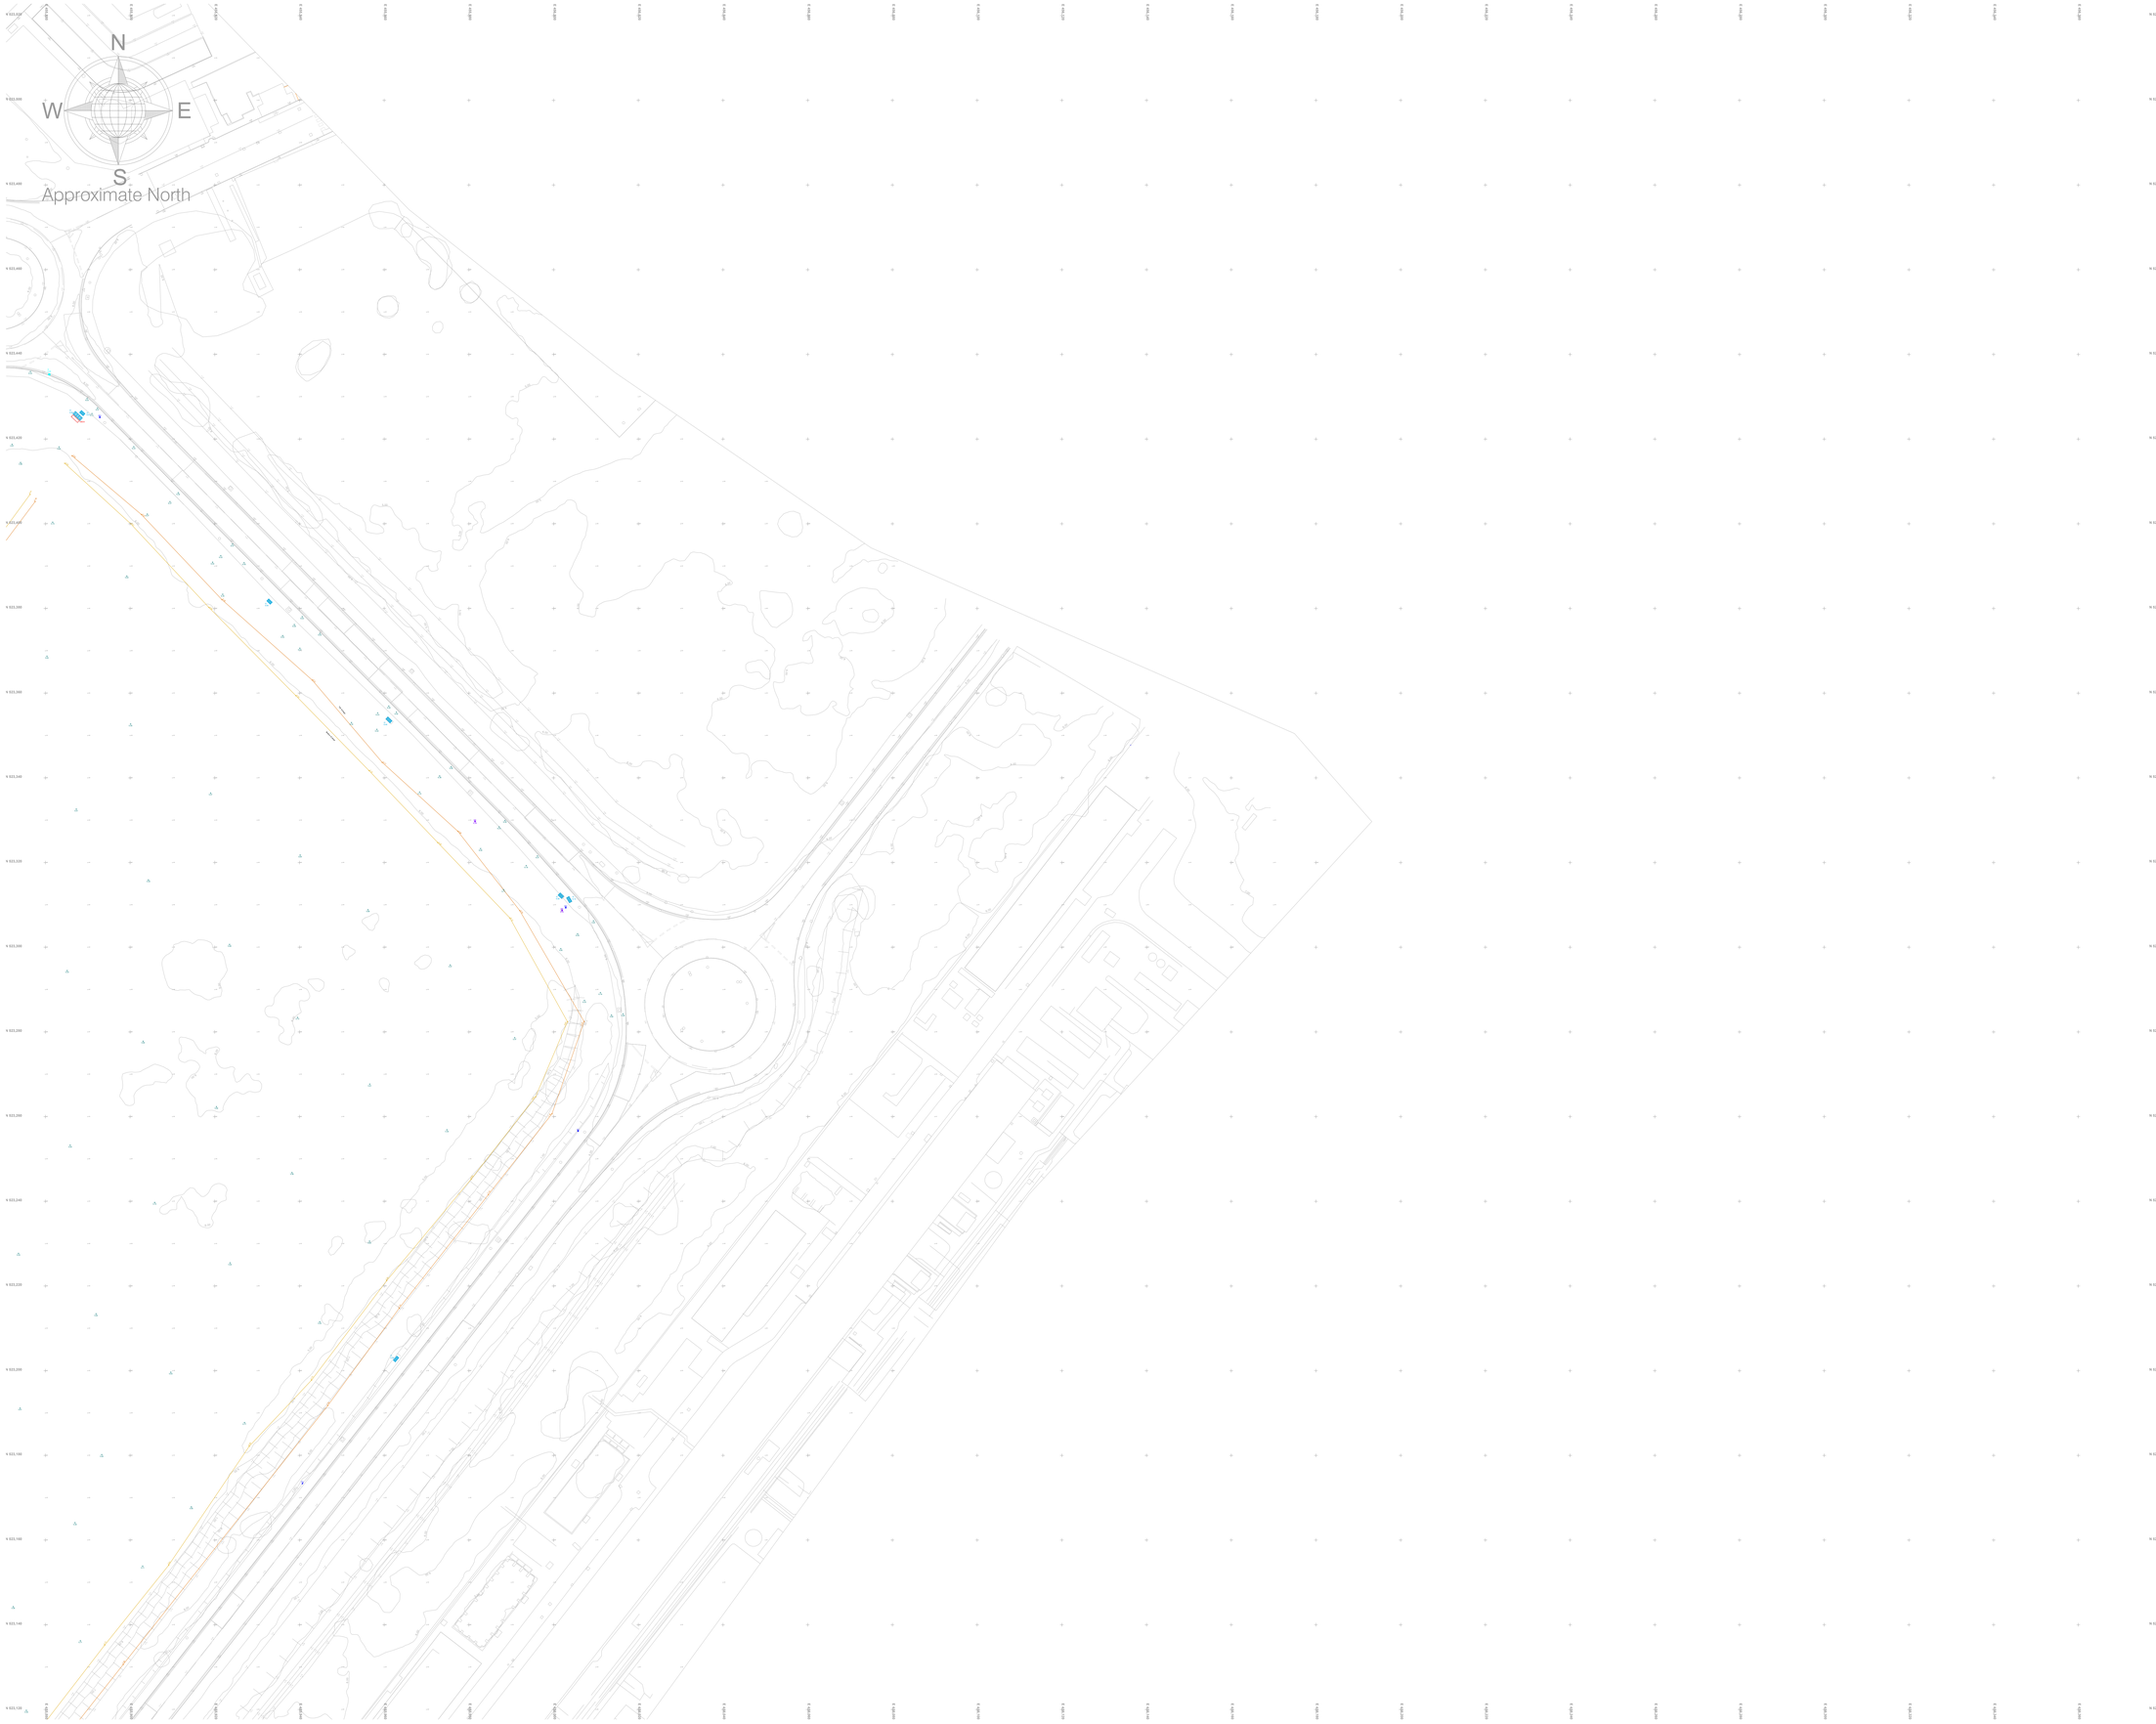

LEGEND

Topographic Linework Features

Air-Con Unit (ACU)
Barrier
Beam Line
Bench
Bin
Bollard Illuminated
Bollard
Bridge
Building Facade
Building
Bus Stop Shelter
Cable Trough
Canopy
Ceiling Line
Centre Line
Column
Column Bottom Line
Column Top Line
Concrete Base/Slab
Contour Major
Contour Minor
Cycle Lane
Ditch
Door
Duct
Electric Box (EBOX)
Fence
Fixture
Flowerbed
Footpath
Grating
Grid Line
Hand Rail
Hedge
Hoarding
Kerb Bottom
Kerb Drop
Kerb Top
Lake
Land Drain
Lift
Opening - Slab
Overhang
Overhead Cables
Parapet
Partition
Parking Meter (PM)
Pipe Line
Platform Train/Tram
Plinth
Pond
Post-box
Rail
Ramp
Red Line Dashed
Red Line Solid
Red Line Double
River Edge
Road Edge
Road Scar Line
Road Text
Roof
Sanitary
Service
Sky Light
Slope Bottom
Slope Top
Slot Drain
Speed Bump
Steel Cladding
Steel Structure
Step Line
Surface Change
Tank
Telephone Box (TB)
Ticket Machine(TVM)
Toilet
Top of Fence Line
Top of Wall Line
Track
Traffic Ctrl Box(TCB)
Tree Drip Line
Tree Line
Trial Pit
Vegetation Line
Vent
Verge Line
Wall Line
Window
Window Glazing
White Line Dashed
White Line Double
White Line Solid
Yellow Line Dashed
Yellow Line Double
Yellow Line Solid

Topographic Point Features

AV 12.24 Air Valve
APEX 12.24 Apex Building
BL 12.24 Bed Level
BB Belisha Beacon
B Bollard
BOLT 12.24 Bolt
BH 12.24 Borehole
Bush
CP CCTV Camera Pole
CE 12.24 Ceiling Elevation
DP 12.24 Dipole
ER Earth Rod
EAVE 12.24 Eave
EP Electrical Pole
FH Fire Hydrant
FL 12.24 Floor Level
GM Gas Meter
GV Gas Valve
Gate
Gully 12.24
Gully Round 12.24
IC 12.24 Inspection Cover
ICTV 12.24 IC - CATV
ICC 12.24 IC - Comms
ICE 12.24 IC - Electric
IC 12.24 IC - Round
ICT 12.24 IC - Telecom
ICTC 12.24 IC - Traffic
IL 12.24 Invert Level
LP Lamp Post
MH 12.24 Manhole
MHF 12.24 MH - Foul
MH 12.24 MH - Round
MHS 12.24 MH - Surface Water
MK 12.24 Marker Post
MW 12.24 Microwave Dish
DP Pipe - Down
POLE Pole
POST Post
RS Road Sign
RE Rodding Eye
SA 12.24 Sector Antenna
SIGN Sign (General)
SOF 12.24 Soffit Level
12.24 Spot Height
SC Stop Cock
TP Telegraph Pole
T12.24 Top of Fence Level
T12.24 Top of Tree Level
T12.24 Top of Wall Level
TL Traffic Light
Tree (TX.XX SX.XX) T=Trunk Radius(m) S=Spread Radius(m)
Tree Coniferous
Tree Deciduous
TT Tree Trunk
V Valve General
WL 12.24 Water Level
WM Water Meter
WV Water Valve

Special Features

DATUM 12.24 Datum Point
Photo Point
Panoramic Photo Point
ID E=XXXX.XXX N=YYYY.YYY H=ZZZ.ZZZ Survey Station
ID E=XXXX.XXX N=YYYY.YYY H=ZZZ.ZZZ Scan Target

Fence Types

B/W	Barbed Wire	C/L	Chain Link	O/B	Open Boarded
C/B	Close Boarded	H	Heras	P/W	Post and Wire
C/I	Corrugated Iron	I/R	Iron Railings	P/R	Post and Rail

Murphy Geospatial Disclaimer

All reasonable endeavours have been used to capture the required data in the survey to the agreed standards of accuracy. Where features have been obstructed due to a lack of access, the areas will be annotated as **'UTS'** (Unable To Survey). The Company shall not be liable for any damages or consequential losses arising from the reliance on survey information beyond its specified scale and accuracy, or survey information used for purposes other than that stated in the Contract of Works.

Any concerns with the survey should be raised with Murphy Geospatial, who will endeavour to promptly provide a remedy. The Client shall not seek recourse through any third party until such time as Murphy Geospatial have had the opportunity to redress any concerns raised.

For full terms and conditions visit **Terms and Conditions** **www.murphygs.com**

Location Plan

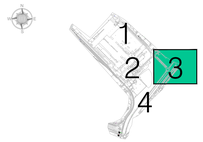

Revisions

Rev	Description	Surveyed by	Drawn by	Checked by
A	First Issue	DH - 28/10/22	NMB - 07/11/22	MM - 08/11/22

Murphy GEOSPATIAL

Geospatial certainty you can trust **murphygs.com**

UK Head Office
39-41 North Road
London
N7 9DP
Phone: (+44) 0203 598 3775
Email: info@murphygs.com

London Manchester Glasgow Belfast Cork Kildare

Client	Wood Group
Project	Green Lithium Refinery
Site Address	Kinkerdale Road Middlesbrough TS6 6UD
Description	Topographical Survey
Survey Grid	OSGB36(15) - Scale Factor Applied
Survey Datum	GNSS - Ordnance Datum Newlyn (ODN)
RICS Band	Band G
Drawing Scale	1:500 @ A0
Drawing Number	MG49340-T-03

© Copyright 2020 MURPHY GEOSPATIAL